

SUITE: 2630



RSF: 3,551

AS-BUILT CONFIGURATION

OFFICES.....	2
RECEPTION.....	1
CONFERENCE ROOMS.....	1
KITCHEN.....	1
OPEN WORK AREA.....	+/-18

Not to scale, furniture and appliances not included

KEY PLAN

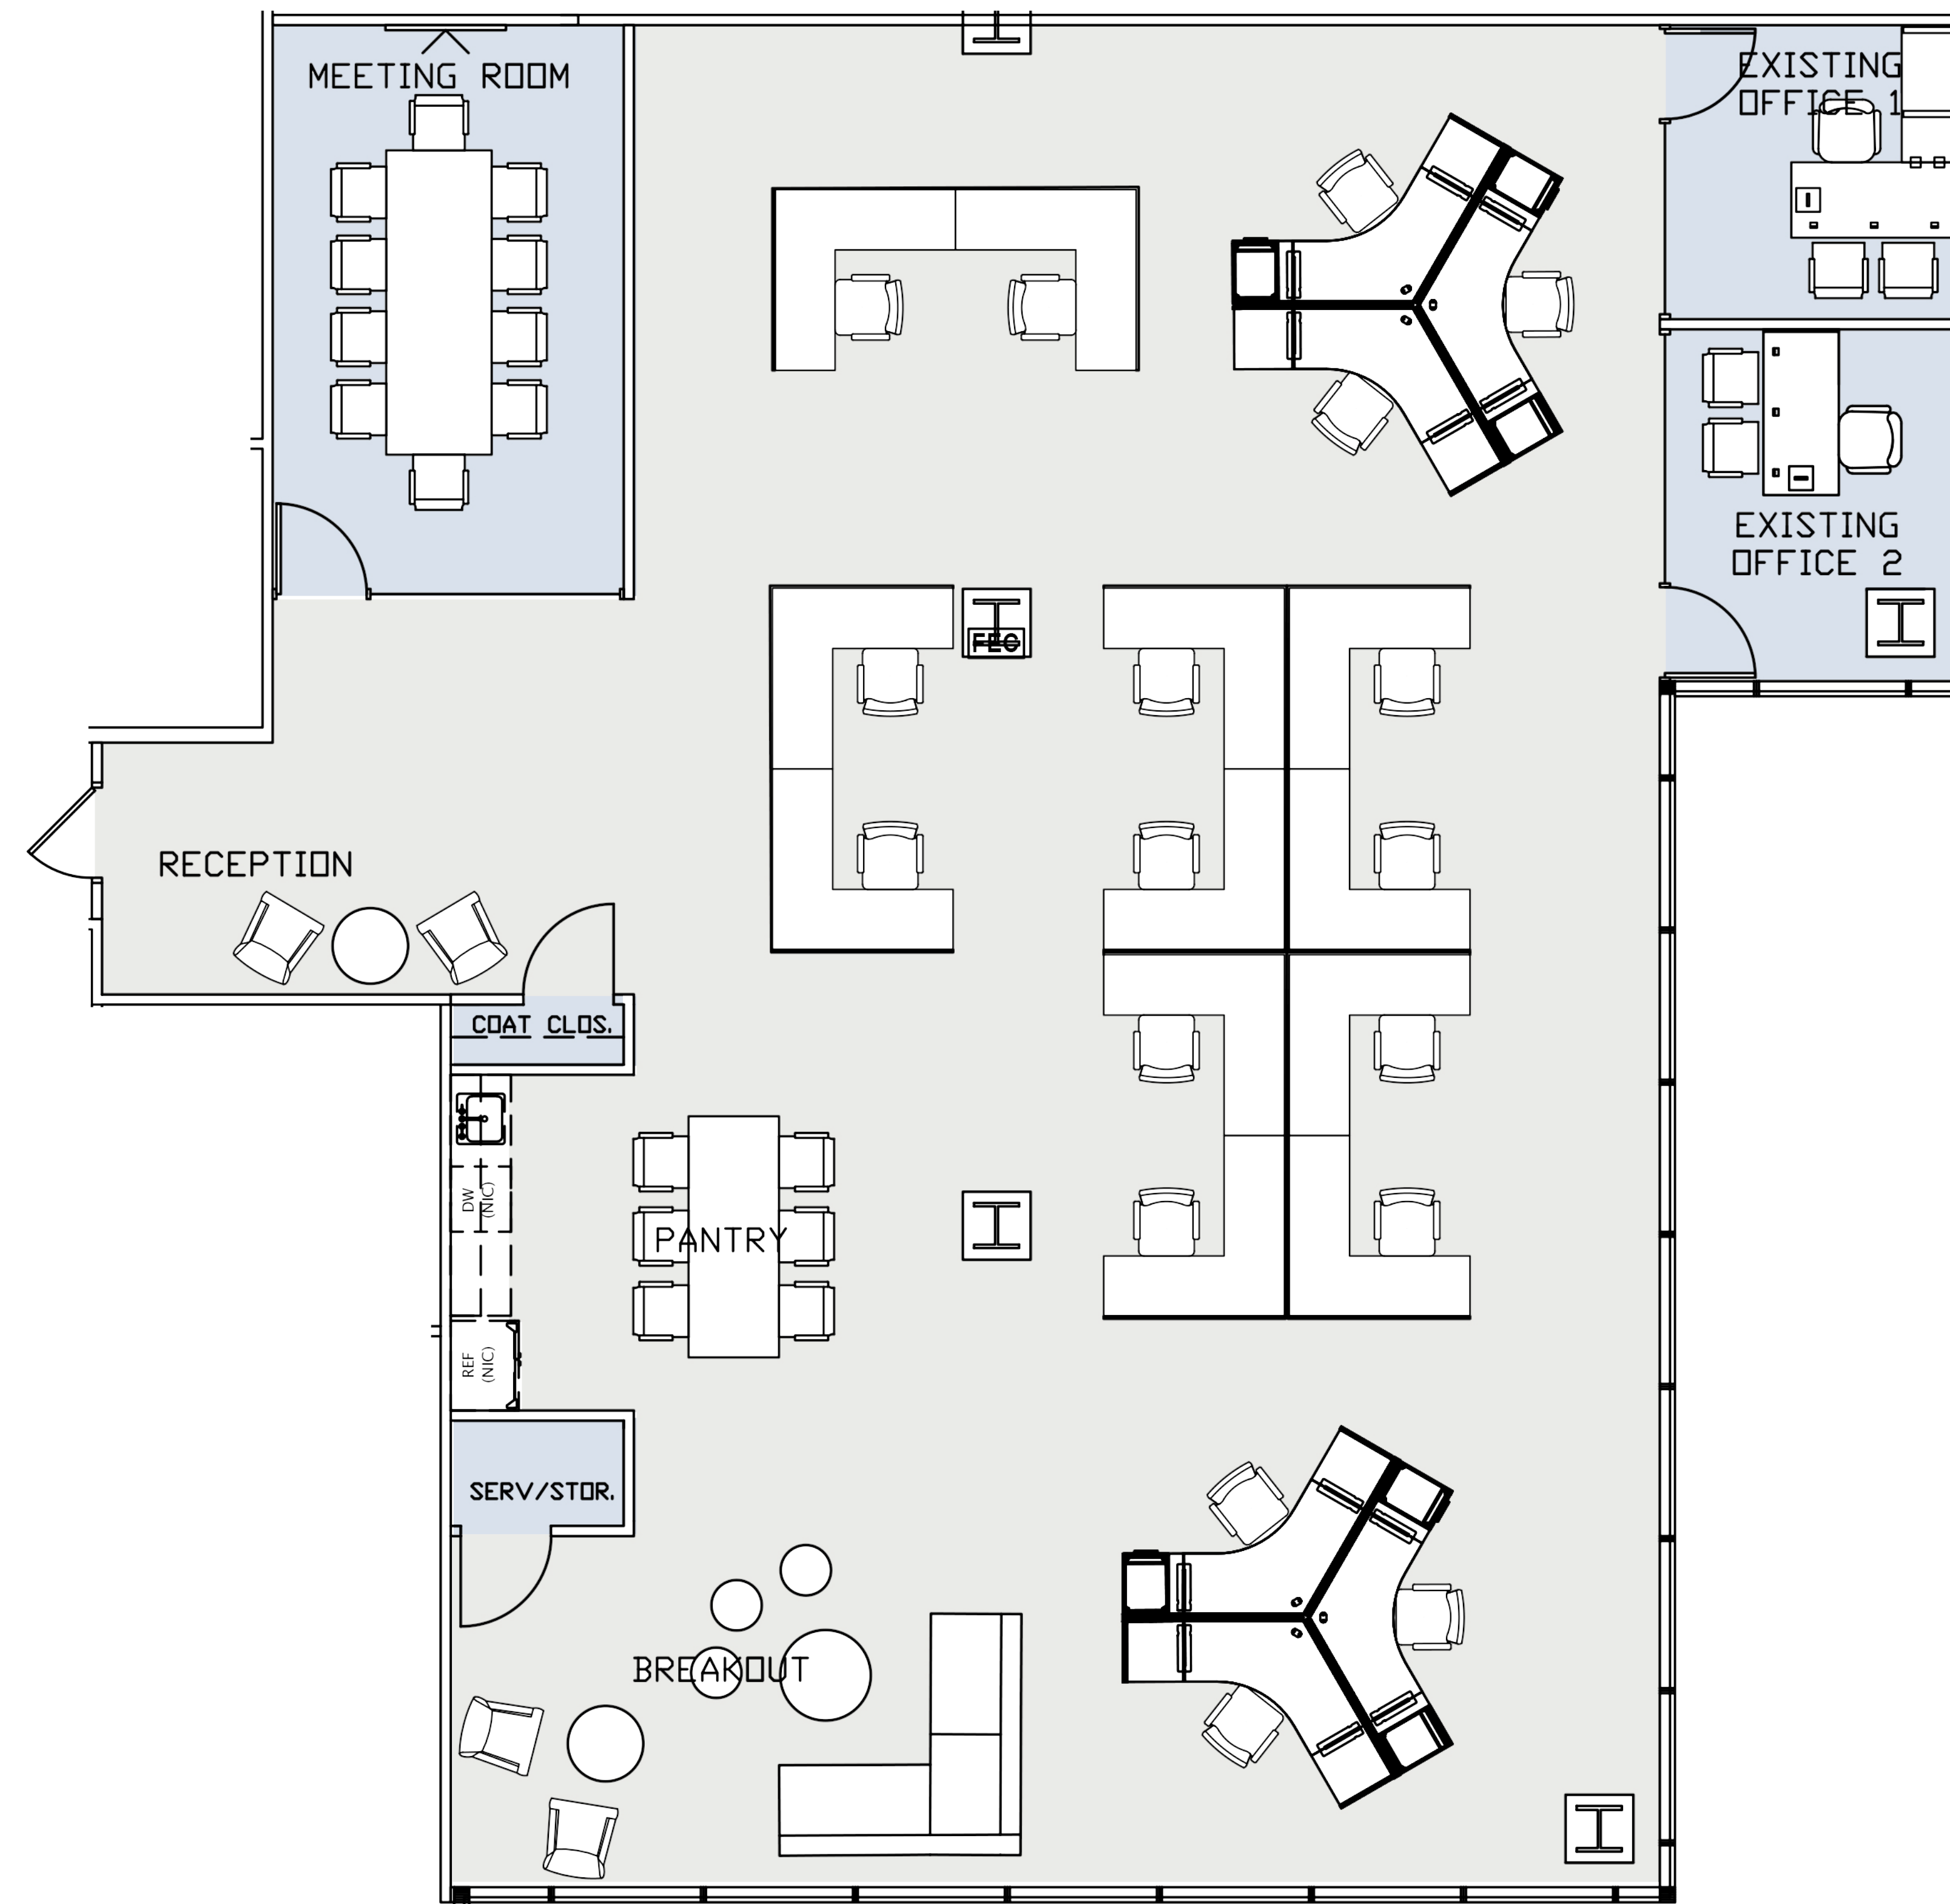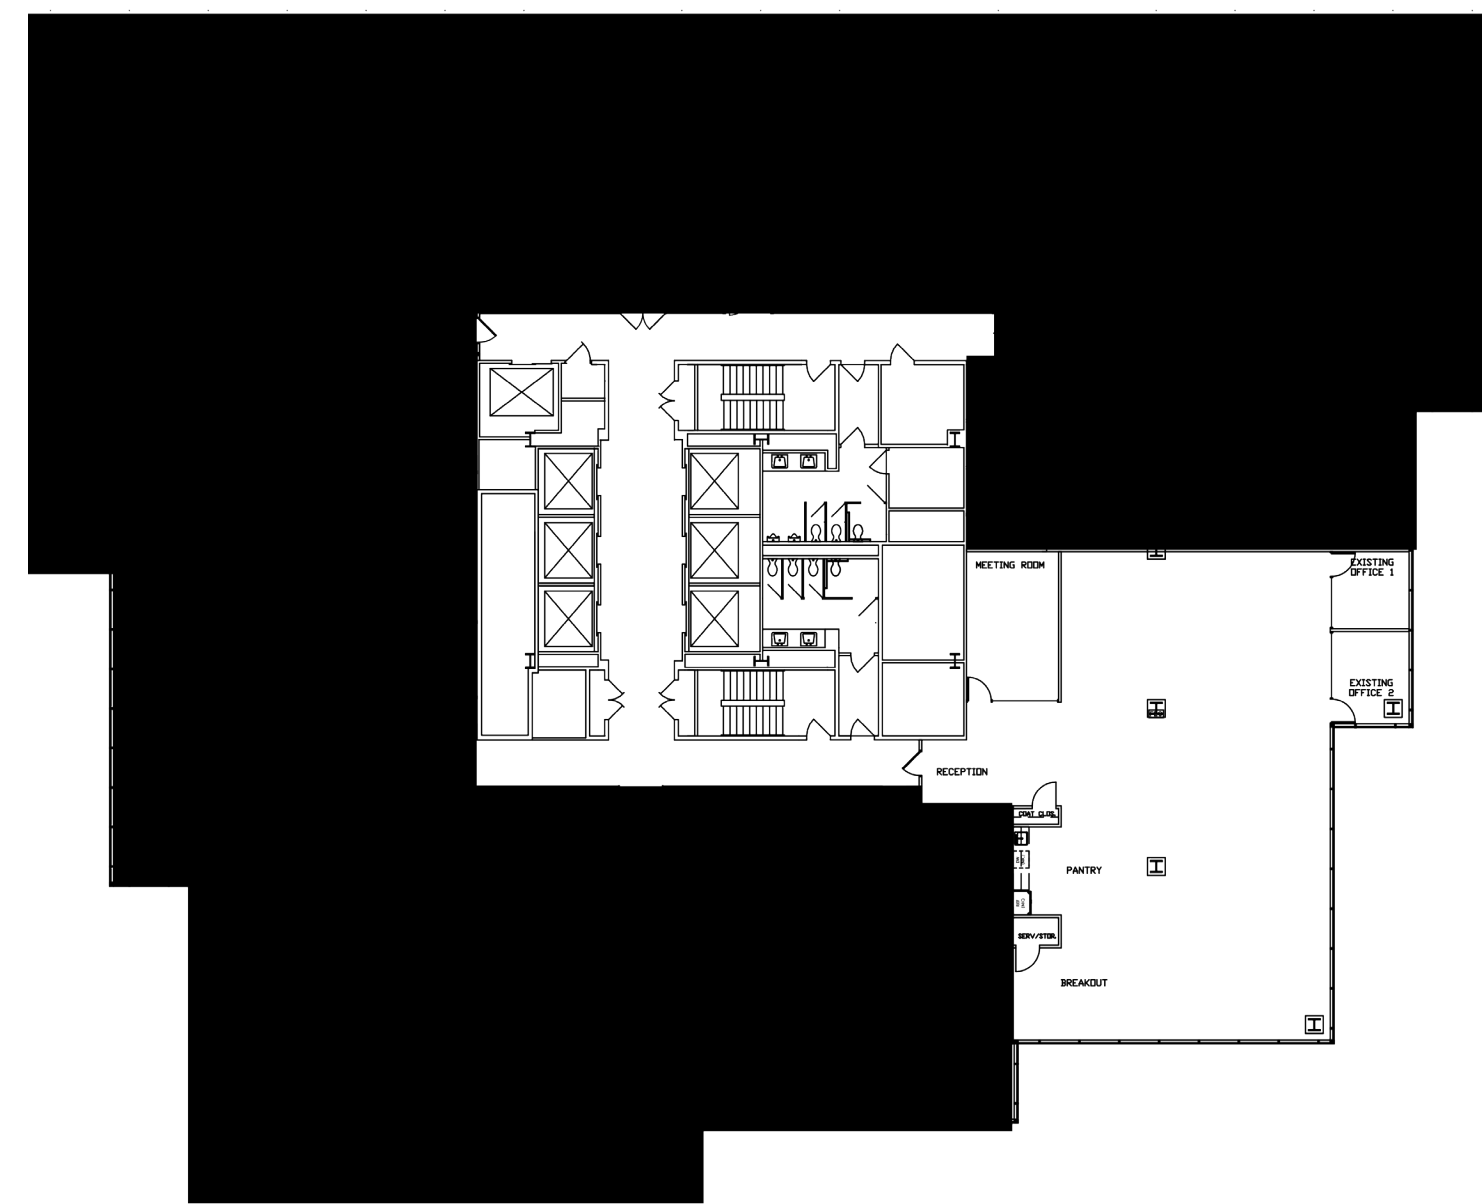

For leasing information please contact:
Benjamin Cleveland
312.819.1236 | ben.cleveland@cushwake.com

Mark Gunderson
312.819.1263 | mark.gunderson@cushwake.com

