


SUITE: 800

RSF: 11,160

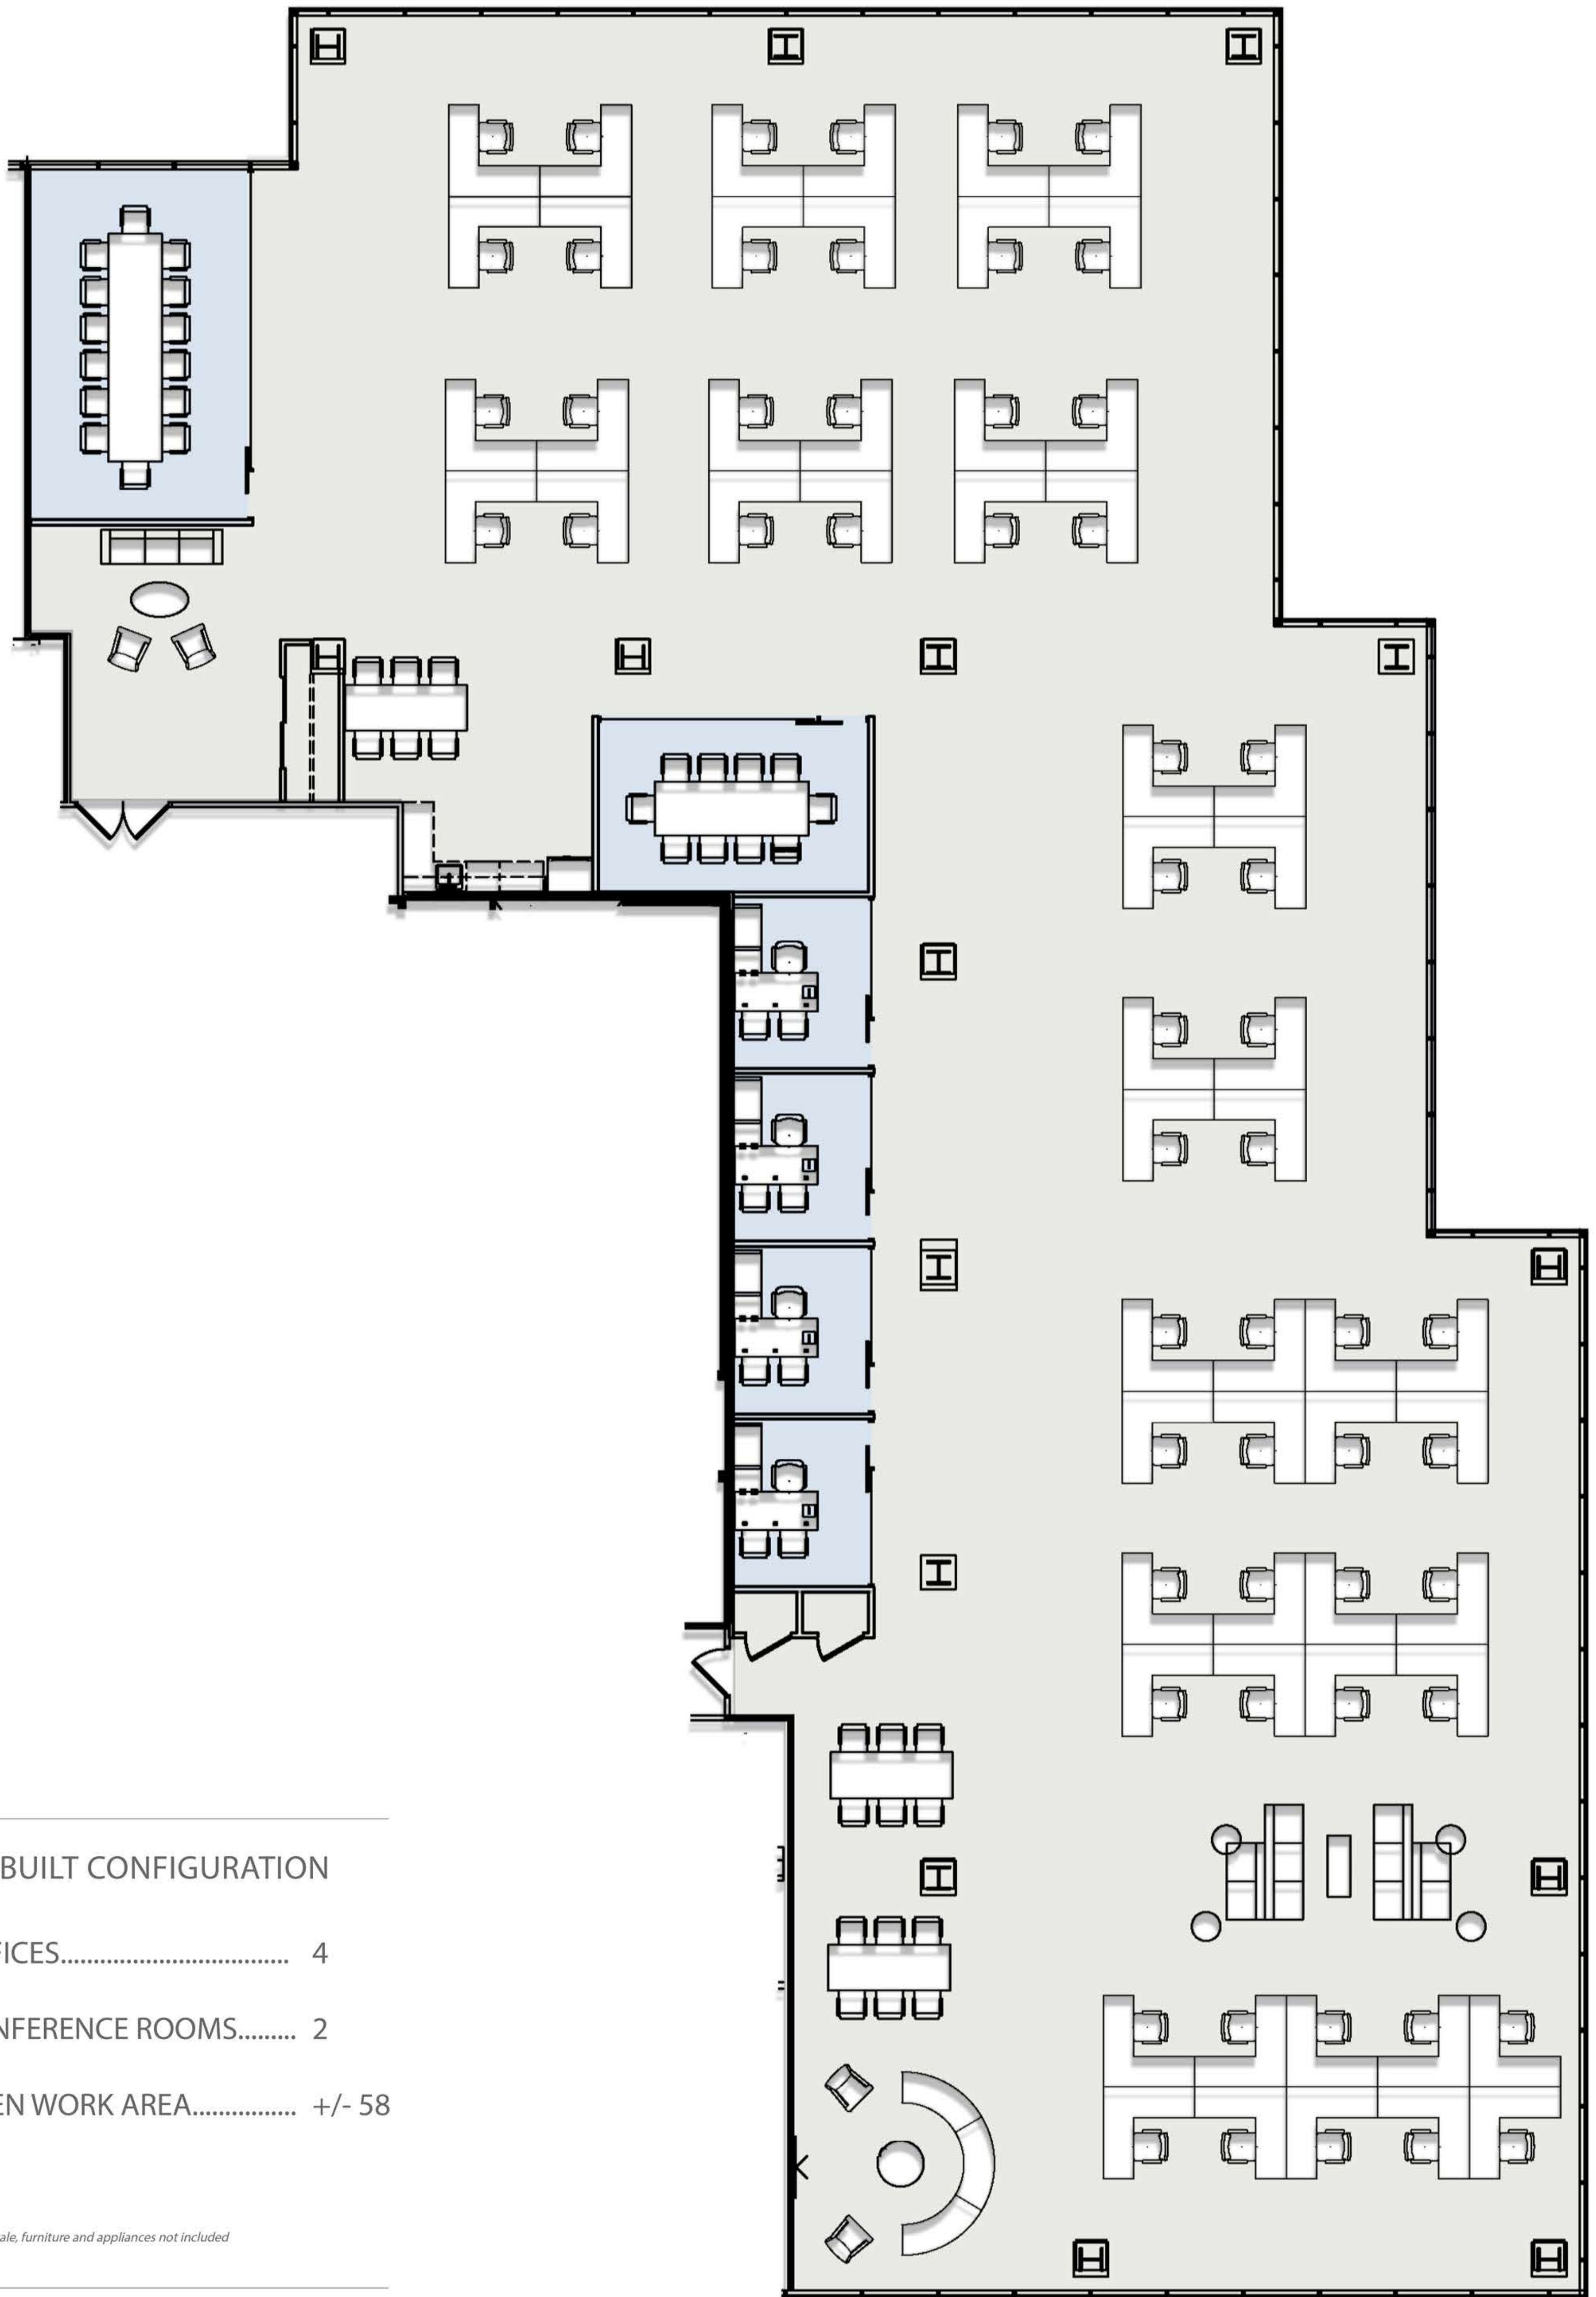

- AS-BUILT CONFIGURATION
- OFFICES..... 4
  - CONFERENCE ROOMS..... 2
  - OPEN WORK AREA..... +/- 58

*Not to scale, furniture and appliances not included*

For leasing information please contact:  
Benjamin Cleveland | Mark Gunderson  
312.819.1236      312.819.1263

